

GENERAL NOTES:

CONTRACTOR TO CONFIRM ALL RELEVANT DIMENSIONS, LEVEL AND DETAILS ON SITE PRIOR TO COMMENCEMENT OF WORKS.

CONTRACTORS TO REPORT ANY DISCREPANCIES TO THE DESIGNER / AUTHOR PRIOR TO COMMENCEMENT OF WORKS.

CONSTRUCTION TO COMPLY WITH ALL RELEVANT BUILDING CODES. STANDARDS OVERRIDE ALL DETAILS IN THIS / THESE DRAWINGS.

DO NOT SCALE THE DRAWINGS.

ALL PRODUCTS AND EQUIPMENT TO BE INSTALLED IN ACCORDANCE WITH MANUFACTURER'S REQUIREMENTS IN A TRADESMAN LIKE MANNER.

LEGEND:

↔ VEHICLE SITE ACCESS



SITE PLAN - WORKS LOCATIONS
SOUTH BANK CONCRETE WORKS

CORE4
Property Services Partners

CONTACT
PHONE: 0499 883 333
DCUNNINGHAM@CORE4SERVICE.COM

ADDRESS
PO BOX 3082
NEWMARKET QLD 4059
ABN: 34 118 244 965

CLIENT / PROJECT
SOUTH BANK CORPORATION
CONCRETE WORKS

DRAWING
SITE PLAN
SCOPE MARK-UP

SCALE NTS JOB NO 48998

DATE 03.06.2024

DWG NO SP01

AUTHOR DYLAN CUNNINGHAM REVISION A

1.0: FOOTPATH AND STEP WORKS

- 1.0.1:

SERVICE LOCATION/S.
- 1.0.2:

HOARDING (TEMPORARY FENCING / BLACK MESH) AND SITE SIGNAGE (COMPLIANCE AND DETOUR).
- 1.1.1:

DEMOLITION / REMOVAL OF CONCRETE (FOOTPATH, APPROX' 16.0M2).
- 1.1.2:

REMOVAL OF ALL WASTE FROM SITE.
- 1.2.1:

SUPPLY AND INSTALLATION OF (APPROX' 16.0M2) F72 MESH ON STANDS.
- 1.2.2:

SUPPLY AND INSTALLATION OF COMPACTION SAND.
- 1.2.3:

SET-UP OF FORMWORK FOR FOOTPATH REINSTATEMENT / STEP EXTENSION.
- 1.2.4:

SUPPLY AND INSTALLATION OF STEEL REINFORCEMENT FOR STEP EXTENSION.
- 1.3.1:

POURING 28PMA CONCRETE, 150MM THICKNESS, COLOUR-MATCH TO EXISTING CONCRETE FOOTPATH.
- 1.3.2:

POURING OF CONCRETE TO FORM STEP EXTENSION, COLOUR-MATHC TO EXISTING STAIRS.
- 1.3.3:

RETURN TO SITE WITHIN 24HRS OF CONCRETE POUR TO CUT SLAB LINES TO MATCH EXISTING FOOTPATH PATTERN.
- 1.4.1:

PAINTING OF STEP EXTENSION IN 'SAFETY' YELLOW.
- 1.4.2:

INSTALLATION OF SAFETY BOLLARD ON STEP EXTENSION CORNER.
- 1.4.3:

INSTALLATION OF NEW TACTILE SQUARES.

2.0: TREE BASE WORKS

- 2.0.1:

SERVICE LOCATION/S.
- 2.0.2:

HOARDING (TEMPORARY FENCING / BLACK MESH) AND SITE SIGNAGE (COMPLIANCE AND DETOUR).
- 2.1.1:

REMOVE AND DISPOSE OF FIVE (5) METAL TREE GRATES.
- 2.1.2:

REMOVAL OF (APPROX' 8.0M2) EXISTING PEBBLECRETE AND EXCESS SOIL AROUND FIVE (5) TREE BASES.
- 2.1.3:

REMOVAL OF ALL WASTE FROM SITE.
- 2.2.1:

SUPPLY AND INSTALLATION OF (APPROX') 1.5M3 OF PEBBLECRETE AROUND FIVE (5) TREE BASES - GREY, COLOUR T.B.C BY CLIENT.

GENERAL NOTES:

CONTRACTOR TO CONFIRM ALL RELEVANT DIMENSIONS, LEVEL AND DETAILS ON SITE PRIOR TO COMMENCEMENT OF WORKS.

CONTRACTORS TO REPORT ANY DISCREPANCIES TO THE DESIGNER / AUTHOR PRIOR TO COMMENCEMENT OF WORKS.


CONSTRUCTION TO COMPLY WITH ALL RELEVANT BUILDING CODES. STANDARDS OVERRIDE ALL DETAILS IN THIS / THESE DRAWINGS.

DO NOT SCALE THE DRAWINGS.

ALL PRODUCTS AND EQUIPMENT TO BE INSTALLED IN ACCORDANCE WITH MANUFACTURER'S REQUIREMENTS IN A TRADESMAN LIKE MANNER.

LEGEND:

- WORK/S SITE.
- TURNING LANE.
- VEHICLE ACCESS TO WORK/S SITE.

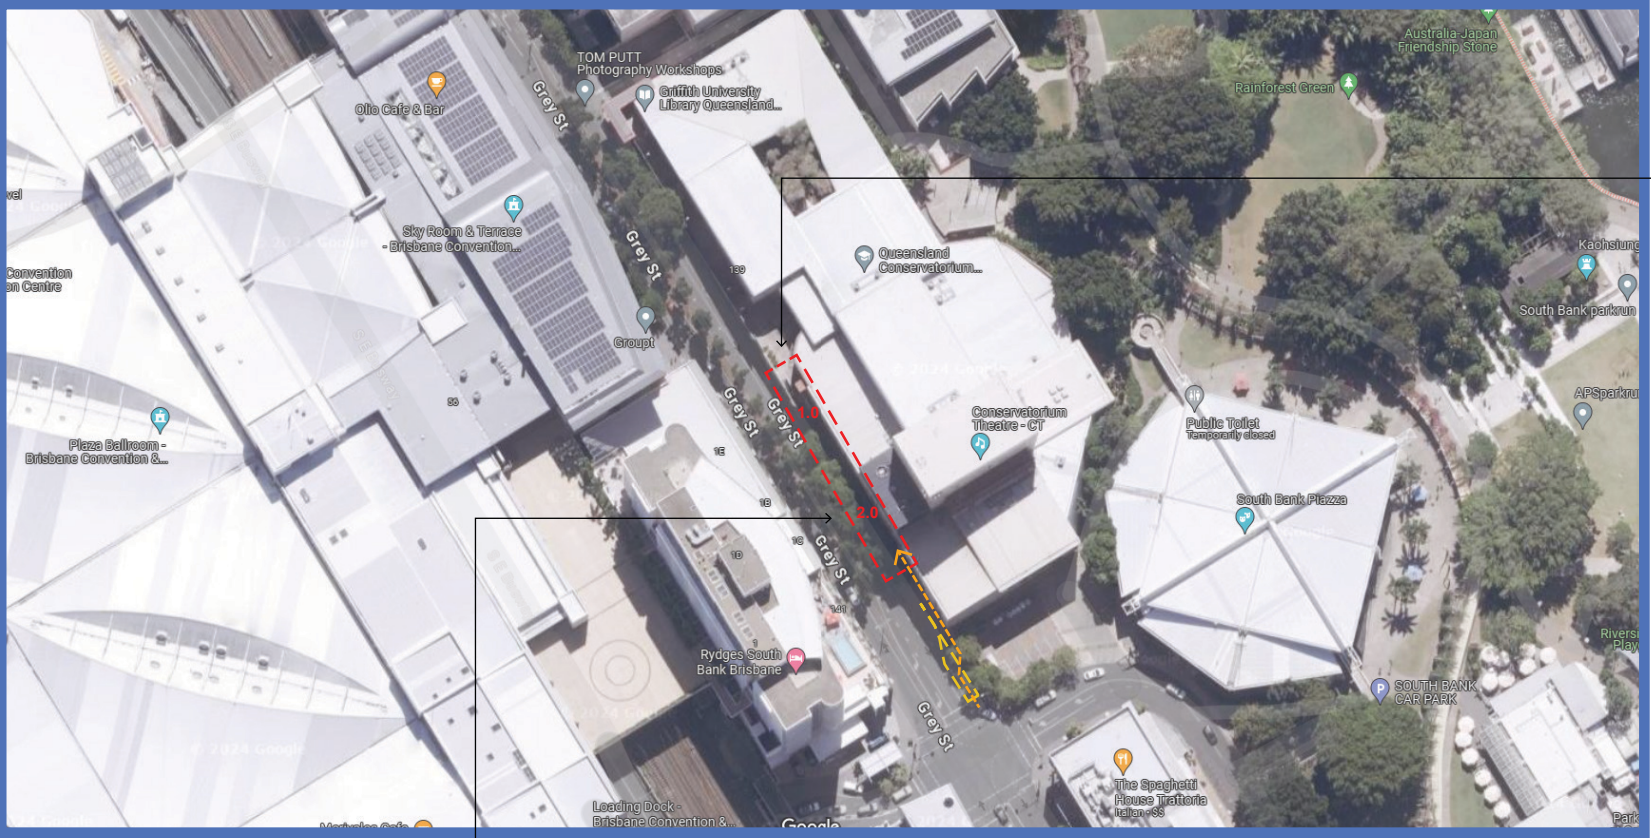

EXTENT OF STEP EXTENSION AND SAFETY BOLLARD PLACEMENT.



EXTENT OF EXCLUSION ZONE - BIKEWAY.



EXTENT OF CONCRETE FOOTPATH REMOVAL / REINSTATEMENT.



EXTENT OF TREE BASE WORK/S.
5 x 1200 x 1200MM BASES.
1 x 1500 x 2000MM BASES.



SCHEDULE & SUBCONTRACTOR NOTES:

- CUTRITE (CONCRETE CUTTING SCHEDULED TO ATTEND SITE FROM 10:00AM MONDAY 10.06.24 TO COMPLETE CONCRETE CUTTING WORKS.
- AK EARTHMOVING SCHEDULED TO ATTEND SITE FROM 7:00AM TUESDAY 11.06.24 (AND RETURN WEDNESDAY 12.06.23 IF REQUIRED, CONFIRMED TUESDAY).
- AK EARTHMOVING TO PROCURE, COLLECT AND DELIVERY CRUSHER DUST TO SITE TUESDAY 11.06.24, OFF-LOADED ONTO A TRAP WITHIN WORKS SITE.
- CONCRETE DELIVERY (BORAL) SCHEDULED FOR 10:00-10:30AM MONDAY 17.06.24. DELIVERY: CHUTE / DIRECT POUR.

NOTE:

TRUCKS / WORK VEHICLES TO BE CONTAINED WITHIN WORKS SITE / EXCLUSION ZONES (TEMPORARY FENCING). TRUCKS / WORK VEHICLES TO ACCESS WORKS SITE (FOOTPATH) VIA TURNING LANE (LEFT HAND TURN TO LITTLE STANLEY STREET) ON GREY STREET. CORE 4 RESPONSIBLE FOR TRAFFIC MANAGEMENT: DESIGNATED TRAFFIC MANAGEMENT OFFICE (HIGH VIS VEST, HARD HAT, LOLLIPOP), BOLLARDS TO CLOSE URNING LANE, DETOUR SIGN/S. TURNING LANE ONLY TO BE CLOSED FOR TRUCKS / WORK VEHICLES ENTERING / LEAVING WORKS SITE.

TEMPORARY FENCE PANELS TO BE RELOCATED / RE-PURPOSED FROM SOUTH BANK PIAZZA REFURBISHMENT WORKS / WORKS SITE - PANELS REMOVED FROM PIAZZA TO BE REPLACED WITH BOLLARDS / EXTENDOR POLES.

‘CONSERVATORIUM’

SOUTH BANK CONCRETE WORKS

CORE4
Property Services Partners

CONTACT
PHONE: 0499 883 333
DCUNNINGHAM@CORE4SERVICE.COM

ADDRESS
PO BOX 3082
NEWMARKET QLD 4059
ABN: 34 118 244 965

CLIENT / PROJECT
SOUTH BANK CORPORATION
CONCRETE WORKS

DRAWING
SITE PLAN
SCOPE MARK-UP

SCALE NTS
DATE 06.06.2024
DWG NO SP02

AUTHOR DYLAN CUNNINGHAM
REVISION B

3.0: FOOTPATH WORKS, CONCRETE RE-LEVELING

- 3.0.1:

SERVICE LOCATION/S.
- 3.0.2:

HOARDING (TEMPORARY FENCING / BLACK MESH) AND SITE SIGNAGE (COMPLIANCE AND DETOUR).
- 3.1.1:

DEMOLITION / REMOVAL OF CONCRETE (FOOTPATH, APPROX' 42.0M2).
- 3.1.2:

DEMOLITION / REMOVAL OF COBBLESTONE STRIPS (NO ALLOWANCE FOR REINSTATEMENT).
- 3.1.3:

DEMOLITION / REMOVAL OF COBBLESTONE STRIPS (ALLOWANCE FOR REINSTATEMENT).
- 3.1.4:

REMOVAL OF ALL WASTE FROM SITE.
- 3.2.1:

SUPPLY AND INSTALLATION OF (APPROX' 42.0M2) F72 MESH ON STANDS.
- 3.2.2:

SUPPLY AND INSTALLATION OF COMPACTION SAND.
- 3.3.1:

POURING OF 28MPA CONCRETE, 150MM THICKNESS, COLOUR-MATCH TO EXISTING CONCRETE FOOTPATH.

4.0: TREE BASE WORKS

- 4.0.1:

SERVICE LOCATION/S.
- 4.0.2:

HOARDING (TEMPORARY FENCING / BLACK MESH) AND SITE SIGNAGE (COMPLIANCE AND DETOUR).
- 4.1.1:

REMOVAL OF (APPROX' 16.0M2) EXISTING PEBBLECRETE AND EXCESS SOIL AROUND SIX (6) TREE BASES.
- 4.1.2:

SUPPLY AND INSTALLATION OF (APPROX' 3.0M3) PEBBLECRETE AROUND SIX (6) TREE BASES.
- 4.2.1:

REMOVAL OF (APPROX' 7.0LM) COBBLESTONE AROUND LAST / SIXTH (6TH) TREE.
- 4.2.2:

DEMOLITION / REMOVAL OF (APPROX' 2.0M2) SECTION OF CONCRETE FOOTPATH.
- 4.2.3:

SUPPLY AND INSTALLATION OF (APPROX' 8.0LM) 200MMH METAL EDGING AROUND TREE BASE, MATCHING EXISTING ADJACENT GARDEN BED.
- 4.3.1:

SUPPLY AND INSTALLATION OF (APPROX' 2.0M2) F72 MESH ON STANDS.
- 4.3.2:

SUPPLY AND INSTALLATION OF COMPACTION SAND.
- 4.4.1:

POURING OF 28MPA CONCRETE, 150MM THICKNESS, COLOUR-MATCH TO EXISTING CONCRETE FOOTPATH.
- 4.4.2:

REINSTATEMENT OF (APPROX' 1.0LM) OF COBBLESTONES.

GENERAL NOTES:

CONTRACTOR TO CONFIRM ALL RELEVANT DIMENSIONS, LEVEL AND DETAILS ON SITE PRIOR TO COMMENCEMENT OF WORKS.

CONTRACTORS TO REPORT ANY DISCREPANCIES TO THE DESIGNER / AUTHOR PRIOR TO COMMENCEMENT OF WORKS.

CONSTRUCTION TO COMPLY WITH ALL RELEVANT BUILDING CODES. STANDARDS OVERRIDE ALL DETAILS IN THIS / THESE DRAWINGS.

DO NOT SCALE THE DRAWINGS.

ALL PRODUCTS AND EQUIPMENT TO BE INSTALLED IN ACCORDANCE WITH MANUFACTURER'S REQUIREMENTS IN A

LEGEND:

- WORK/S SITE.
- VEHICLE ACCESS TO WORK/S SITE.



EXTENT OF TREE BASE WORKS.
6 x 1500 x 1500MM BASES.



EXTENT OF CONCRETE FOOTPATH
REMOVAL / REINSTATEMENT.



GARDEN BED / EDGING TO BE
MATCHED / REPLICATED.



EXTENT OF NEW GARDEN BED /
EDGING AND CONCRETE FOOTPATH
REMOVAL / RESTATEMENT.

SCHEDULE & SUBCONTRACTOR NOTES:

- CUTRITE (CONCRETE CUTTING SCHEDULED TO ATTEND SITE FROM 10:00AM TUESDAY 18.06.24 TO COMPLETE CONCRETE CUTTING WORKS.
- AK EARTHMOVING SCHEDULED TO ATTEND SITE FROM 7:00AM TUESDAY 18.06.24 (AND RETURN WEDNESDAY 19.06.23 IF REQUIRED, CONFIRMED TUESDAY).
- CONCRETE DELIVERY (BORAL) SCHEDULED FOR 10:00-10:30AM AND 11:00-11:30AM MONDAY 24.06.24. 2 x 4.03 DELIVERIES, CONCRETE DELIVERY: LINE PUMP FROM LITTLE STANLEY STREET.
- TRUCKS / WORK VEHICLES TO BE CONTAINED WITHIN WORKS SITE / EXCLUSION ZONES (TEMPORARY FENCING). TRUCKS / WORK VEHICLES TO ACCESS WORKS SITE VIA PARKLAND'S RAMP LOCATED ON LITTLE STANLEY STREET (ALIGNED WITH ERNEST STREET). CORE 4 RESPONSIBLE FOR TRAFFIC MANAGEMENT: DESIGNATED TRAFFIC MANAGEMENT OFFICE (HIGH VIS VEST, HARD HAT, LOLLIPOP). NO VEHICLES TO STRAY FROM PATHWAYS - NO VEHICLES ON GRASS (ANYWHERE WITHIN THE PARKLAND'S) OR SOFTFALL (AROUND FLOWSTATE).

'FLOWSTATE'

SOUTH BANK CONCRETE WORKS

CORE4
Property Services Partners

CONTACT
PHONE: 0499 883 333
DCUNNINGHAM@CORE4SERVICE.COM

ADDRESS
PO BOX 3082
NEWMARKET QLD 4059
ABN: 34 118 244 965

CLIENT / PROJECT
SOUTH BANK CORPORATION
CONCRETE WORKS

DRAWING
SITE PLAN
SCOPE MARK-UP

SCALE NTS
DATE 06.06.2024
DWG NO SP03

AUTHOR DYLAN CUNNINGHAM
REVISION B

5.0: FOOTPATH WORKS, CONCRETE RE-LEVELING.

- 5.0.1: SET-UP OF EXCLUSION ZONE/S AND SAFETY BARRIERS.
- 5.1.1: CONCRETE CUT AND GRIND (BETWEEN GLENELG AND ERNEST STREET, CINEMA SIDE ONLY) OF (APPROX' 15.0LM) OF LIPPED AND LIFTED CONCRETE FOOTPATH.
- 5.1.2: REMOVAL OF ALL WASTE FROM SITE.
- 5.2.1: SITE / FOOTPATH CLEAN (DAILY).

NOTE: WORKS TO BE COMPLETED BETWEEN 7:00AM - 9:00AM EACH DAY,

GENERAL NOTES:

CONTRACTOR TO CONFIRM ALL RELEVANT DIMENSIONS, LEVEL AND DETAILS ON SITE PRIOR TO COMMENCEMENT OF WORKS.

CONTRACTORS TO REPORT ANY DISCREPANCIES TO THE DESIGNER / AUTHOR PRIOR TO COMMENCEMENT OF WORKS.


CONSTRUCTION TO COMPLY WITH ALL RELEVANT BUILDING CODES. STANDARDS OVERRIDE ALL DETAILS IN THIS / THESE DRAWINGS.

DO NOT SCALE THE DRAWINGS.

ALL PRODUCTS AND EQUIPMENT TO BE INSTALLED IN ACCORDANCE WITH MANUFACTURER'S REQUIREMENTS IN A TRADESMAN LIKE MANNER.

LEGEND:

WORK/S SITE.

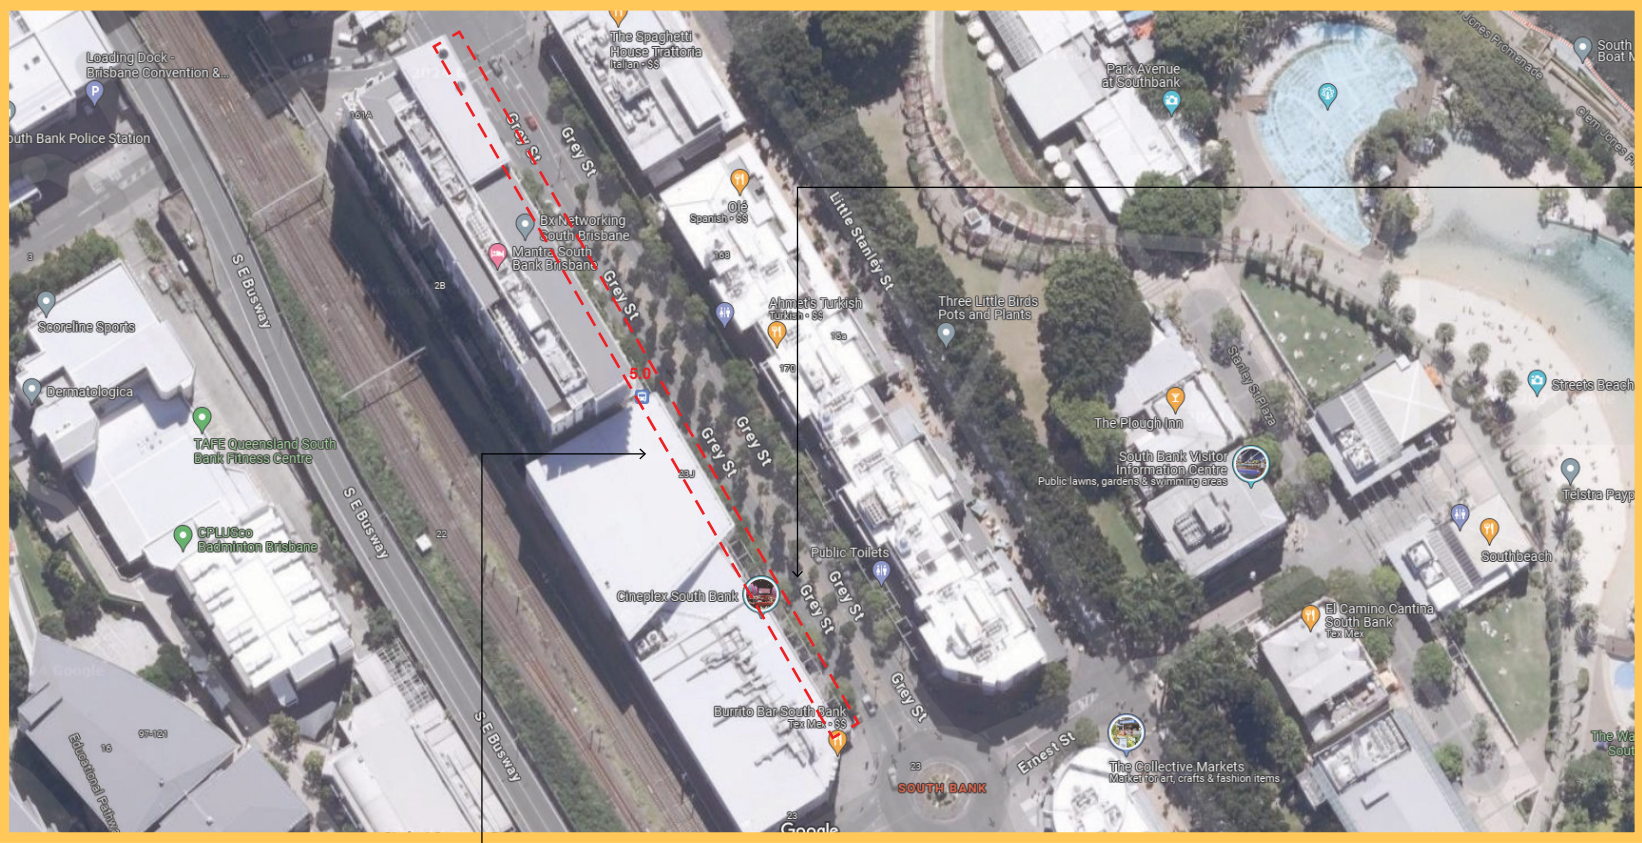

EXTENT OF CONCRETE RE-LEVELING.

LOCATION REFERENCE	DEPTH X WIDTH (MM)
OZELLO	20 x 1200
NEGRONI	15 x 400
NEGRONI	10 x 1200
NEGRONI	20 x 800
SAN CHURRO	20 x 800
SAN CHURRO	10 x 1200
EZY MART	15 x 600
EZY MART	20 x 1500
EZY MART	10 x 300
CINEMA	10 x 400
CINEMA	10 x 600
NEO SUSHI	10 x 600
NEO SUSHI	10 x 800



TYPICAL LIFTED / LIPPED CONCRETE FOOTPATH FOR CUTTING / GRINDING.



‘GREY STREET FOOTPATH’
SOUTH BANK CONCRETE WORKS

CORE4
Property Services Partners

CONTACT
PHONE: 0499 883 333
DCUNNINGHAM@CORE4SERVICE.COM

ADDRESS
PO BOX 3082
NEWMARKET QLD 4059
ABN: 34 118 244 965

CLIENT / PROJECT
SOUTH BANK CORPORATION
CONCRETE WORKS

DRAWING
SITE PLAN
SCOPE MARK-UP

SCALE NTS JOB NO 48998
DATE 12.06.2024
DWG NO SP04

AUTHOR DYLAN CUNNINGHAM REVISION C