


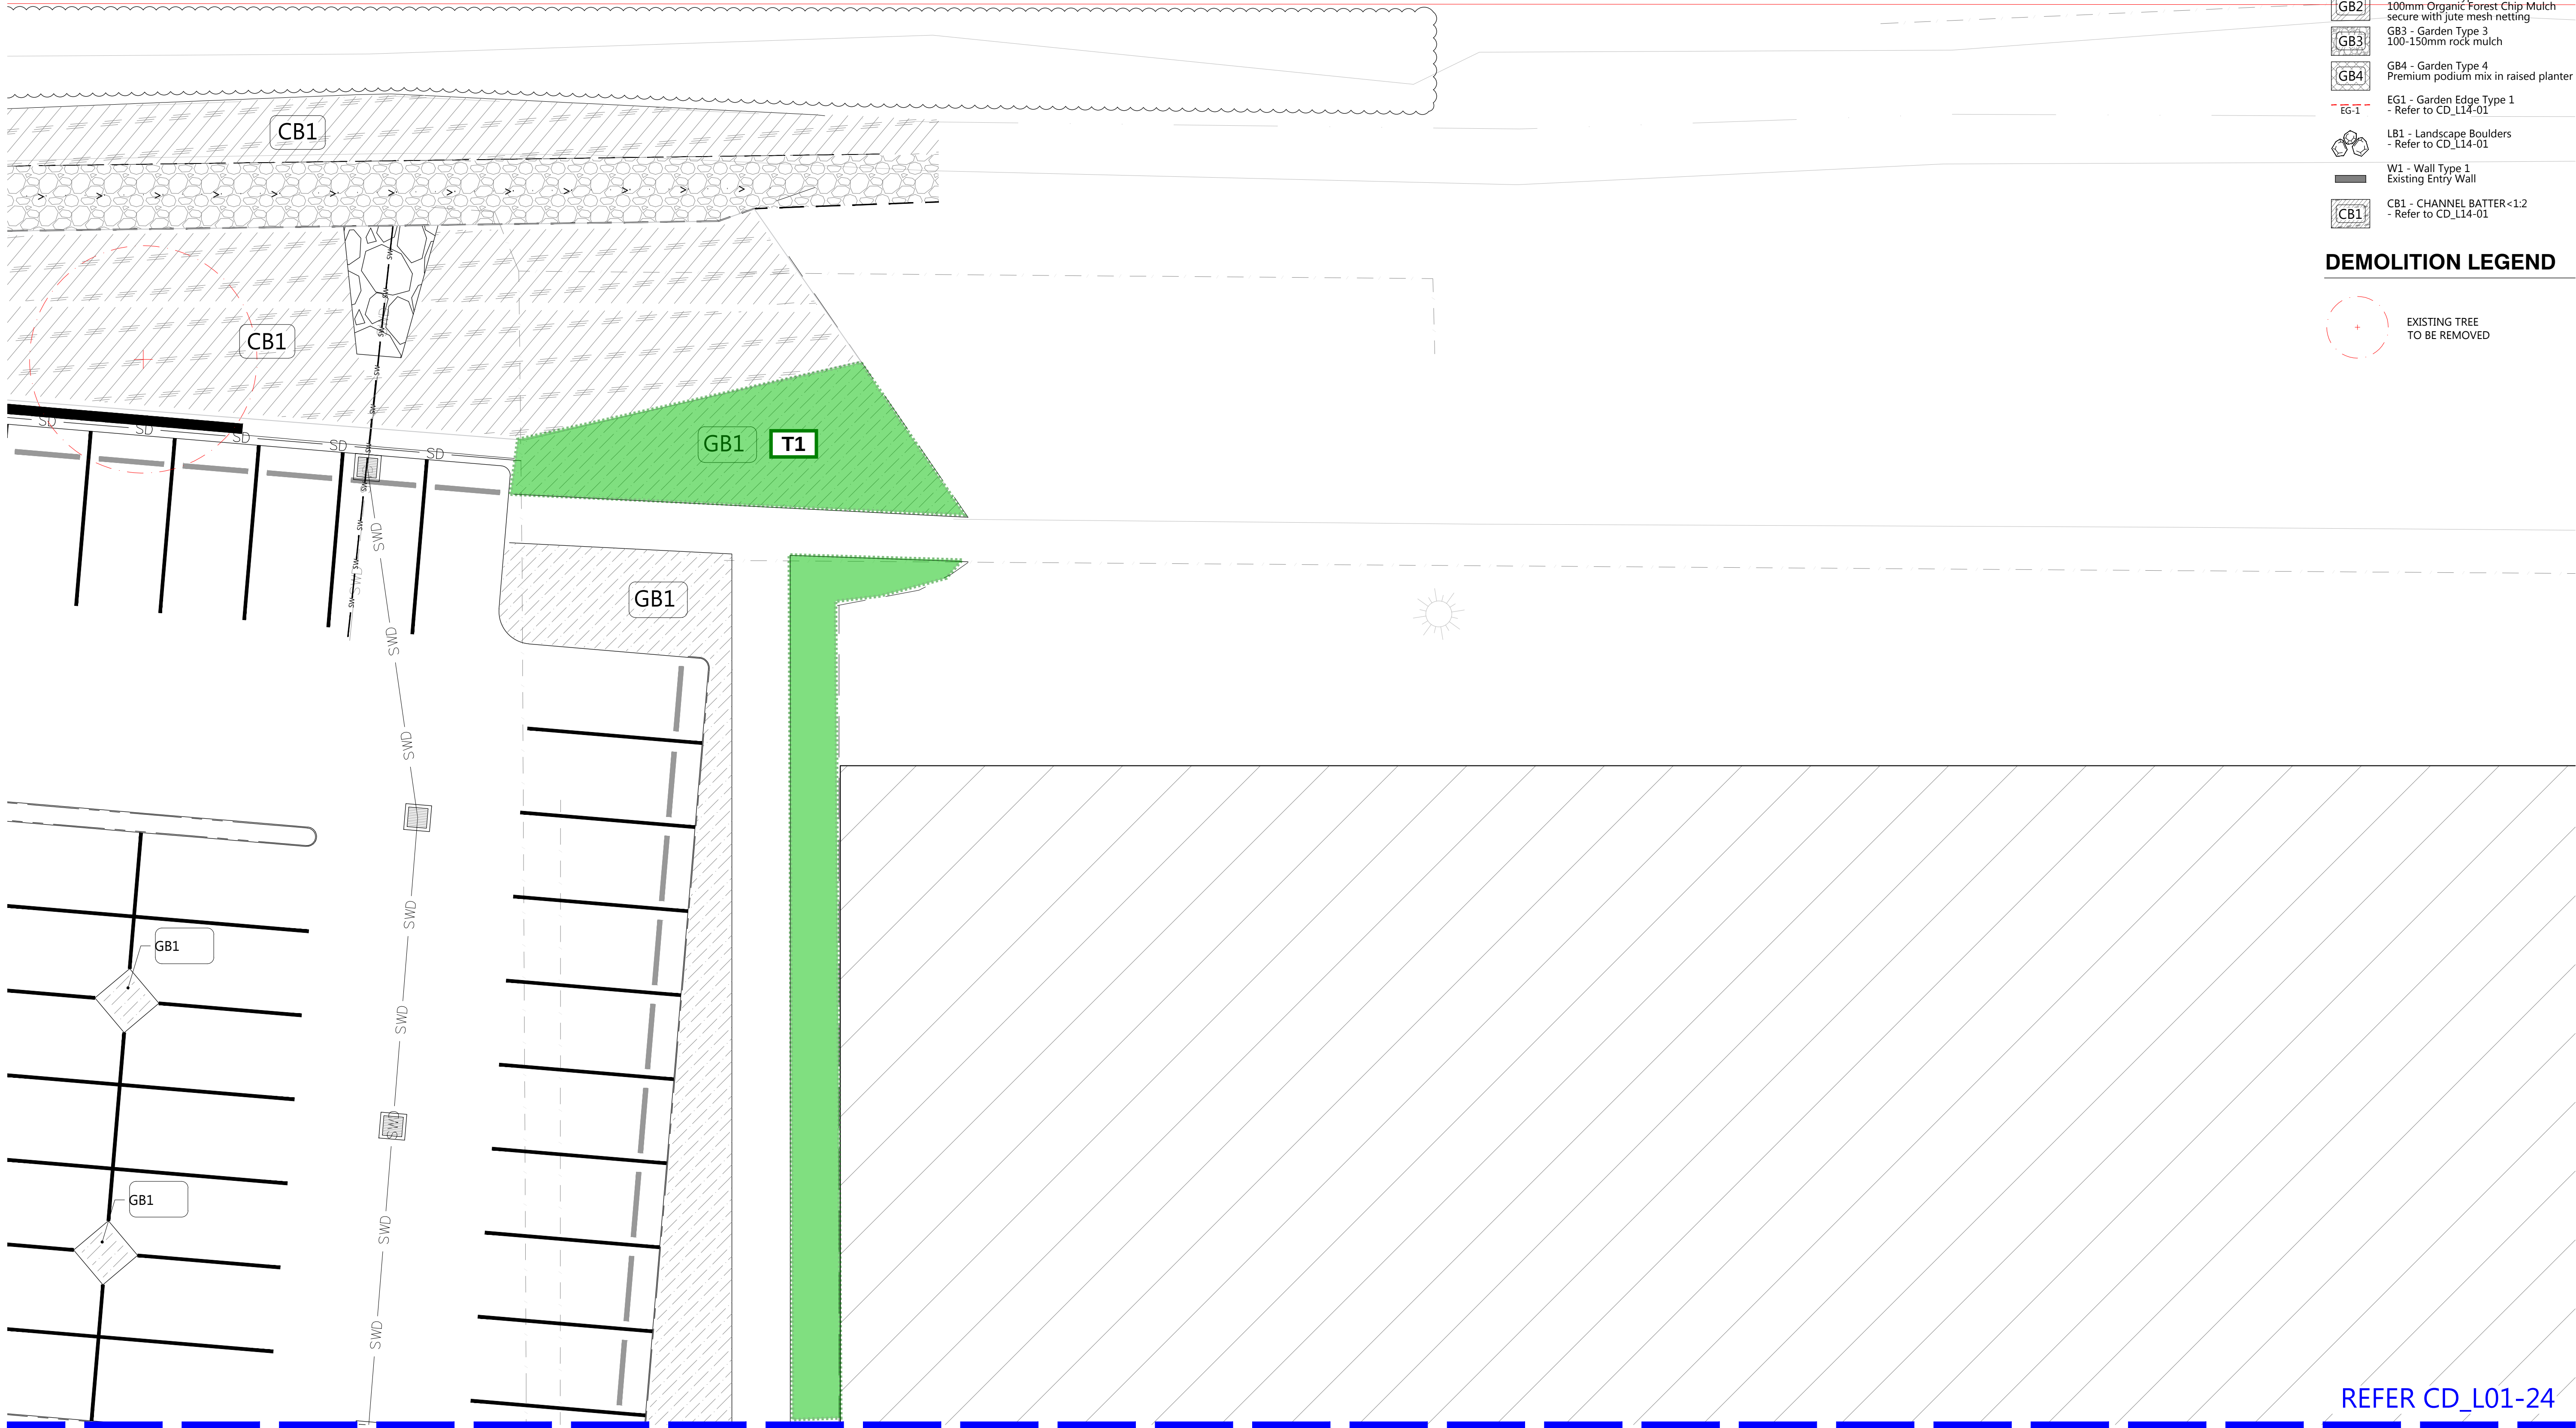


SURFACE LEGEND

- T1 - Turf
- GB1 - Garden Type 1
Organic Forest Chip
Mulch laid 100mm thick
- GB2 - Garden Type 2
100mm Organic Forest Chip Mulch
secure with jute mesh netting
- GB3 - Garden Type 3
100-150mm rock mulch
- GB4 - Garden Type 4
Premium podium mix in raised planter
- EG1 - Garden Edge Type 1
- Refer to CD_L14-01
- LB1 - Landscape Boulders
- Refer to CD_L14-01
- W1 - Wall Type 1
Existing Entry Wall
- CB1 - CHANNEL BATTER <1:2
- Refer to CD_L14-01

DEMOLITION LEGEND

- EXISTING TREE
TO BE REMOVED

REFER CD_L01-24

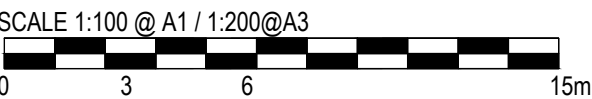

REV.	DESCRIPTION	BY	DATE
A	FOR CO-ORDINATION	AL	21/01/2020
B	FOR CONSTRUCTION	ZL	03/02/2020
C	FOR CONSTRUCTION	ZL	02/03/2020

DRAWING STATUS

FOR CONSTRUCTION

CONSULTANTS

PROJECT

REDEVELOPMENT WORKS

TITLE
LANDSCAPE EXTERNAL WORKS

GROUND FLOOR
FINISHES PLAN (PART B)

DATE

03/02/2020

SCALE

@ A1

CLIENT NO.

DRAWN BY

ZL

CHECKED BY

CS

APPROVED BY

PROJECT NO.

PHASE

DRAWING NO.

REV.

CD

L01-22

C

COPYRIGHT

REPRODUCTION OF THESE DRAWINGS IN WHOLE OR PART IS STRICTLY FORBIDDEN
WITHOUT THE WRITTEN PERMISSION OF PAYNTERS. USE FIGURED DIMENSIONS IN
PREFERENCE TO SCALE. ALL DIMENSIONS TO BE CONFIRMED ON SITE.



REFER CD_L01-21

SURFACE LEGEND

- T1

T1 - Turf
- GB1

GB1 - Garden Type 1
Organic Forest Chip
Mulch laid 100mm thick
- GB2

GB2 - Garden Type 2
100mm Organic Forest Chip Mulch
secure with jute mesh netting
- GB3

GB3 - Garden Type 3
100-150mm rock mulch
- GB4

GB4 - Garden Type 4
Premium podium mix in raised planter
- EG-1

EG1 - Garden Edge Type 1
- Refer to CD_L14-01
- LB1

LB1 - Landscape Boulders
- Refer to CD_L14-01
- W1

W1 - Wall Type 1
Existing Entry Wall
- CB1

CB1 - CHANNEL BATTER<1:2
- Refer to CD_L14-01

DEMOLITION LEGEND

- EXISTING TREE
TO BE REMOVED

REFER CD_L01-25

No Walls Here
Demolished

Bluestone
Scour
Protection

Bluestone
Scour
Protection

Conc

GB3

GB1

GB1

LB1

GB1

SCALE 1:100 @ A1 / 1:200@A3
0 3 6 15m

REV.	DESCRIPTION	BY	DATE
A	FOR CO-ORDINATION	AL	21/01/2020
B	FOR CONSTRUCTION	ZL	03/02/2020
C	FOR CONSTRUCTION	ZL	02/03/2020

DRAWING STATUS

CONSULTANTS

FOR CONSTRUCTION

COPYRIGHT
REPRODUCTION OF THESE DRAWINGS IN WHOLE OR PART IS STRICTLY FORBIDDEN
WITHOUT THE WRITTEN PERMISSION OF PAYNTERS. USE FIGURED DIMENSIONS IN
PREFERENCE TO SCALE. ALL DIMENSIONS TO BE CONFIRMED ON SITE.

PROJECT

REDEVELOPMENT WORKS

TITLE

LANDSCAPE EXTERNAL WORKS

GROUND FLOOR
FINISHES PLAN (PART C)

DATE

03/02/2020

SCALE

@ A1

CLIENT NO.

PROJECT NO.

DRAWN BY

ZL

CHECKED BY

CS

APPROVED BY

PHASE

DRAWING NO.

REV.

CD L01-23

C

REFER CD_L01-24

PROPOSED
EXTENTION

SURFACE LEGEND

- T1 - Turf
- GB1 - Garden Type 1
Organic Forest Chip
Mulch laid 100mm thick
- GB2 - Garden Type 2
100mm Organic Forest Chip Mulch
secure with jute mesh netting
- GB3 - Garden Type 3
100-150mm rock mulch
- GB4 - Garden Type 4
Premium podium mix in raised planter
- EG1 - Garden Edge Type 1
- Refer to CD_L14-01
- LB1 - Landscape Boulders
- Refer to CD_L14-01
- W1 - Wall Type 1
Existing Entry Wall
- CB1 - CHANNEL BATTER <1:2
- Refer to CD_L14-01

DEMOLITION LEGEND

EXISTING TREE
TO BE REMOVED

ENTRY

PROPOSED
EXTENTION

DOSA
20.0 m²

REV.	DESCRIPTION	BY	DATE
A	FOR CO-ORDINATION	AL	21/01/2020
B	FOR CONSTRUCTION	ZL	03/02/2020
C	FOR CONSTRUCTION	ZL	02/03/2020

DRAWING STATUS

FOR CONSTRUCTION

CONSULTANTS

COPYRIGHT
REPRODUCTION OF THESE DRAWINGS IN WHOLE OR PART IS STRICTLY FORBIDDEN
WITHOUT THE WRITTEN PERMISSION OF PAYNTERS. USE FIGURED DIMENSIONS IN
PREFERENCE TO SCALE. ALL DIMENSIONS TO BE CONFIRMED ON SITE.

PROJECT

REDEVELOPMENT WORKS

TITLE
LANDSCAPE EXTERNAL WORKS

GROUND FLOOR
FINISHES PLAN (PART F)

SCALE 1:100 @ A1 / 1:200 @ A3
0 3 6 15m

DATE 03/02/2020	DRAWN BY ZL
SCALE @ A1	CHECKED BY CS
CLIENT NO.	APPROVED BY
PROJECT NO.	PHASE
DRAWING NO.	REV.

CD L01-26 C